



DEPARTMENT OF REGULATORY AND ECONOMIC RESOURCES (RER)  
BOARD AND CODE ADMINISTRATION DIVISION

## NOTICE OF ACCEPTANCE (NOA)

MIAMI-DADE COUNTY  
PRODUCT CONTROL SECTION  
11805 SW 26 Street, Room 208  
T (786) 315-2590 F (786) 315-2599  
[www.miamidade.gov/economy](http://www.miamidade.gov/economy)

Regency Plus, Inc.  
1024 Locust Gap Highway  
Mount Carmel, PA 17851

### SCOPE:

This NOA is being issued under the applicable rules and regulations governing the use of construction materials. The documentation submitted has been reviewed and accepted by Miami-Dade County RER - Product Control Section to be used in Miami Dade County and other areas where allowed by the Authority Having Jurisdiction (AHJ).

This NOA shall not be valid after the expiration date stated below. The Miami-Dade County Product Control Section (In Miami Dade County) and/or the AHJ (in areas other than Miami Dade County) reserve the right to have this product or material tested for quality assurance purposes. If this product or material fails to perform in the accepted manner, the manufacturer will incur the expense of such testing and the AHJ may immediately revoke, modify, or suspend the use of such product or material within their jurisdiction. RER reserves the right to revoke this acceptance, if it is determined by Miami-Dade County Product Control Section that this product or material fails to meet the requirements of the applicable building code.

This product is approved as described herein, and has been designed to comply with the Florida Building Code, including the High Velocity Hurricane Zone.

**DESCRIPTION:** Series "5305 Tilt" White PVC Double Hung Window -- L.M.I.

**APPROVAL DOCUMENT:** Drawing No. RPLS0064, titled "Series 5305 Tilt Double Hung Impact Vinyl Window", sheets 1 through 8 of 8, dated 01/12/09, with revision E dated 12/07/13, prepared by PTC, LLC, signed and sealed by Robert J. Amoroso, P.E., bearing the Miami-Dade County Product Control Revision stamp with the Notice of Acceptance number and expiration date by the Miami-Dade County Product Control Section.

**MISSILE IMPACT RATING:** Large and Small Missile Impact Resistant

**LABELING:** Each unit shall bear a permanent label with the manufacturer's name or logo, city, state, model/series, and following statement: "Miami-Dade County Product Control Approved", unless otherwise noted herein.

**RENEWAL** of this NOA shall be considered after a renewal application has been filed and there has been no change in the applicable building code negatively affecting the performance of this product.

**TERMINATION** of this NOA will occur after the expiration date or if there has been a revision or change in the materials, use, and/or manufacture of the product or process. Misuse of this NOA as an endorsement of any product, for sales, advertising or any other purposes shall automatically terminate this NOA. Failure to comply with any section of this NOA shall be cause for termination and removal of NOA.

**ADVERTISEMENT:** The NOA number preceded by the words Miami-Dade County, Florida, and followed by the expiration date may be displayed in advertising literature. If any portion of the NOA is displayed, then it shall be done in its entirety.

**INSPECTION:** A copy of this entire NOA shall be provided to the user by the manufacturer or its distributors and shall be available for inspection at the job site at the request of the Building Official.

This NOA revises and renews NOA# 12-0223.11 and consists of this page 1 and evidence pages E-1 and E-2, as well as approval document mentioned above.

The submitted documentation was reviewed by Manuel Perez, P.E.



*MP*  
11/7/14

NOA No. 13-1007.10  
Expiration Date: May 06, 2019  
Approval Date: December 05, 2013  
Page 1

NOTICE OF ACCEPTANCE: EVIDENCE SUBMITTED

**A. DRAWINGS**

1. Manufacturer's die drawings and sections.  
*(Submitted under NOA#09-0122.05)*
2. Drawing No **RPLS0064**, titled "Series 5305 Tilt Double Hung Impact Vinyl Window", sheets 1 through 8 of 8, dated 01/12/09, with revision E dated 12/07/13, prepared by PTC, LLC, signed and sealed by Robert J. Amoruso, P.E.

**B. TESTS**

1. Test report on: 1) Air Infiltration Test, per FBC, TAS 202-94  
2) Uniform Static Air Pressure Test, Loading per FBC TAS 202-94  
3) Water Resistance Test, per FBC, TAS 202-94  
4) Large Missile Impact Test per FBC, TAS 201-94  
5) Cyclic Wind Pressure Loading per FBC, TAS 203-94  
6) Forced Entry Test, per FBC 2411 3.2.1, TAS 202-94  
along with marked-up drawings and installation diagram of series 5305 tilt double hung vinyl window, prepared by National Certified Testing Laboratories, Test Report No. **NCTL-110-11422-2**, dated 10/02/08, with revision dated 01/08/09, and addendum letter dated 03/12/09, all signed and sealed by Harold E. Rupp, P.E.  
*(Submitted under NOA#09-0122.05)*

**C. CALCULATIONS**

1. Anchor verification calculations and structural analysis, complying with FBC 2007, prepared by PTC, LLC, dated 01/12/09 and 04/02/09, signed and sealed by Paul E. Winter, P.E.  
*(Submitted under NOA#09-0122.05)*
2. Glazing complies with **ASTM E1300-04**

**D. QUALITY ASSURANCE**

1. Miami-Dade Department of Regulatory and Economic Resources (RER)

**E. MATERIAL CERTIFICATIONS**

1. Notice of Acceptance No. **13-0129.27** issued to **E.I. DuPont DeNemours & Co., Inc.** for their "**DuPont Butacite® PVB Interlayer**" dated 04/11/13, expiring on 12/11/16.
2. Notice of Acceptance No. **12-1120.02**, issued to **Royal Window and Door Profiles, Plant 13**, for their **White Rigid PVC Exterior Extrusions**, approved on 02/28/13, expiring on 02/28/18.



Manuel Perez, P.E.  
Product Control Examiner  
NOA No. 13-1007.10

Expiration Date: May 06, 2019  
Approval Date: December 05, 2013

Regency Plus, Inc.


NOTICE OF ACCEPTANCE: EVIDENCE SUBMITTED

**F. STATEMENTS**

1. Statement letter of conformance, complying with **FBC-2010**, and of no financial interest, dated February 07, 2012, signed and sealed by Robert J. Amoruso, P.E.  
*(Submitted under previous NOA#12-0223.11)*
2. Laboratory compliance letter in the Test Report no. **NCTL-110-11422-2**, issued by National Certified Testing Laboratories, dated 10/02/08 revision dated 01/08/09, signed and sealed by Harold E. Rupp, P.E.  
*(Submitted under NOA#09-0122.05)*

**G. OTHER**

1. Notice of Acceptance No. **12-0223.11**, issued to Regency Plus, Inc. for their Series "5305 Tilt" White PVC Double Hung Window – L.M.I., approved on 04/19/12 and expiring on 05/06/14.

  
Manuel Perez, P.E.  
Product Control Examiner  
NOA No. 13-1007.10  
Expiration Date: May 06, 2019  
Approval Date: December 05, 2013

# REGENCY PLUS

## SERIES 5305 TILT DOUBLE HUNG IMPACT VINYL WINDOW

### INSTALLATION ANCHORAGE DETAILS

#### GENERAL NOTES:

1. THE PRODUCT ANCHORAGE SHOWN HEREIN IS DESIGNED TO COMPLY WITH THE HIGH VELOCITY HURRICANE ZONE (HVHZ) OF THE 2007 AND 2010 FLORIDA BUILDING CODE (FBC) AND AT THE DESIGN PRESSURE STATED HEREIN.
2. THE PRODUCT DETAILS CONTAINED HEREIN ARE BASED UPON SIGNED AND SEALED TEST REPORT # NCTL-110-11422-2 DATED 12/01/08, ADDENDUM DATED 11/05/08 AND ADDENDUM II DATED 03/10/09 AND ASSOCIATED LABORATORY STAMPED DRAWINGS AND WERE TESTED IN ACCORDANCE WITH CURRENT DADE COUNTY PROTOCOLS.
3. ADEQUACY OF THE EXISTING STRUCTURAL CONCRETE MASONRY AND 2X FRAMING AS A MAIN WIND FORCE RESISTING SYSTEM CAPABLE OF WITHSTANDING AND TRANSFERRING APPLIED PRODUCT LOADS TO THE STRUCTURE IS THE RESPONSIBILITY OF THE ENGINEER OR ARCHITECT OF RECORD AND TO BE REVIEWED BY AGENCY HAVING JURISDICTION (AHJ).
4. 1X AND 2X BUCKS (WHEN USED) SHALL BE DESIGNED AND ANCHORED TO PROPERLY TRANSFER ALL LOADS TO THE STRUCTURE. BUCK DESIGN AND INSTALLATION IS THE RESPONSIBILITY OF THE ENGINEER OR ARCHITECT OF RECORD AND TO BE REVIEWED BY AHJ.
5. IN AREAS WHERE WIND-BORNE DEBRIS PROTECTION REQUIREMENTS EXIST, USE OF AN APPROVED IMPACT PROTECTIVE SYSTEM IS NOT REQUIRED.
6. WINDOW FRAME AND PANEL MATERIAL: RIGID VINYL PVC PER NOA # 12-1120.02.
7. GLASS MEETS THE REQUIREMENTS OF ASTM E1300-04e1. SEE SHEET 6 FOR GLAZING DETAIL.
8. DESIGNATION "X" STANDS FOR THE FOLLOWING:  
X: OPERABLE PANEL
9. A 1/3 INCREASE IN ALLOWABLE STRESS FOR WIND LOADS WAS NOT USED IN THE DESIGN OF THE PRODUCT(S) SHOWN HEREIN. WIND LOAD DURATION FACTOR ( $C_d = 1.0$ ) HAS BEEN USED FOR WOOD ANCHOR DESIGN.

#### INSTALLATION NOTES:

1. ONE (1) INSTALLATION ANCHOR IS REQUIRED AT EACH ANCHOR LOCATION SHOWN.
2. THE NUMBER OF INSTALLATION ANCHORS DEPICTED IS THE MINIMUM NUMBER OF ANCHORS TO BE USED FOR PRODUCT INSTALLATION.
3. SHIM AS REQUIRED AT EACH INSTALLATION ANCHOR WITH LOAD BEARING SHIM(S). MAXIMUM ALLOWABLE SHIM SIZE IS 1/4 INCH. SHIM WHERE SPACE OF 1/16 INCH OR GREATER OCCURS. SHIM(S) SHALL BE CONSTRUCTED OF HIGH DENSITY PLASTIC OR BETTER.
4. FOR INSTALLATION INTO WOOD FRAMING, USE #12 WOOD SCREWS OF SUFFICIENT LENGTH TO ACHIEVE 1 1/2 INCH MINIMUM EMBEDMENT. MINIMUM EDGE DISTANCE IS 7/8 INCHES.
5. FOR INSTALLATION THROUGH 1X BUCK TO CONCRETE / MASONRY, OR DIRECTLY INTO CONCRETE / MASONRY, USE 3/16 INCH ITW TAPCONS OF SUFFICIENT LENGTH TO ACHIEVE 1 1/4 INCH MINIMUM EMBEDMENT. MINIMUM EDGE DISTANCE IS 2-5/8 INCHES. MINIMUM ANCHOR SEPARATION IS 2 1/4 INCH.
6. MINIMUM EMBEDMENT AND EDGE DISTANCE EXCLUDE WALL FINISHES, INCLUDING BUT NOT LIMITED TO STUCCO, FOAM, BRICK VENEER AND SIDING.
7. FOR CONCRETE BLOCK, DO NOT INSTALL INSTALLATION ANCHORS INTO MORTAR JOINTS. EDGE DISTANCE IS MEASURED FROM FREE EDGE OF BLOCK OR EDGE OF MORTAR JOINT INTO FACE SHELL OF BLOCK.
8. INSTALLATION ANCHOR CAPACITIES FOR PRODUCTS HEREIN ARE BASED ON SUBSTRATE MATERIALS WITH THE FOLLOWING PROPERTIES:
  - A. WOOD - PRESSURE TREATED (PT) SOUTHERN YELLOW PINE. MINIMUM SPECIFIC GRAVITY OF 0.55. LUMBER MUST COMPLY WITH FBC SECTIONS 2411.3.3.3 AND 2326.2 AS TO WOOD PROTECTION.
  - B. CONCRETE - MINIMUM COMPRESSIVE STRENGTH OF 3192 psi, AND COMPLIES WITH ACI 301.
  - C. MASONRY - STRENGTH CONFORMANCE TO ASTM C-90.


TABLE OF CONTENTS		
SHEET	REV.	SHEET DESCRIPTION
1	D	GENERAL NOTES, INSTALLATION NOTES & D.P. CHART
2	D	ELEVATION & ANCHOR LAYOUT
3	D	ELEVATION & ANCHOR LAYOUT
4	D	VERTICAL SECTIONS
5	D	VERTICAL SECTIONS
6	D	HORIZONTAL SECTIONS & GLAZING DETAIL
7	D	BILL OF MATERIALS AND COMPONENTS
8	D	COMPONENTS & CORNER DETAIL

DESIGN PRESSURE RATING (PSF)	IMPACT RATING
±55.0	LARGE MISSILE IMPACT

PROJECT #413-1019				
REV	DESCRIPTION	DATE	BY	SMC
E	REVISE PVC MANUF. AND NOA NO.	12/7/13	RJA	
D	UPDATE TO 2010 FBC	02/07/12	TJH	
C	PER MIAMI DADE COMMENTS 3/18/09	4/1/09		


REGENCY PLUS 1024 LOCUST GAP HIGHWAY MT. CARMEL, PA. 17851				
TITLE: SERIES 5305 TILT DOUBLE HUNG IMPACT VINYL WINDOW GENERAL AND INSTALLATION NOTES				
DRAWN BY:	DATE:	DRAWING NO:	SHEET:	1 OF 8
BB	1/12/09	RPLS0084		
SCALE:	N.T.S.			
REV:	E			
PTC Product Design Group, LLC PO Box 520775, Longwood, FL 32752-0775 321-690-1788 info@ptc-corp.com FBPE Cert. of Auth. No. 25935				

Robert J. Amoroso, P.E.  
Florida P.E. No. 49752

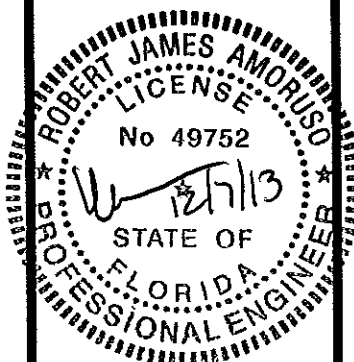


PRODUCT REVISED  
as complying with the Florida  
Building Code  
Acceptance No. 13-1007-10  
Expiration Date 12/31/13  
By *Mamuel J. [Signature]*  
Miami Dade Product Control



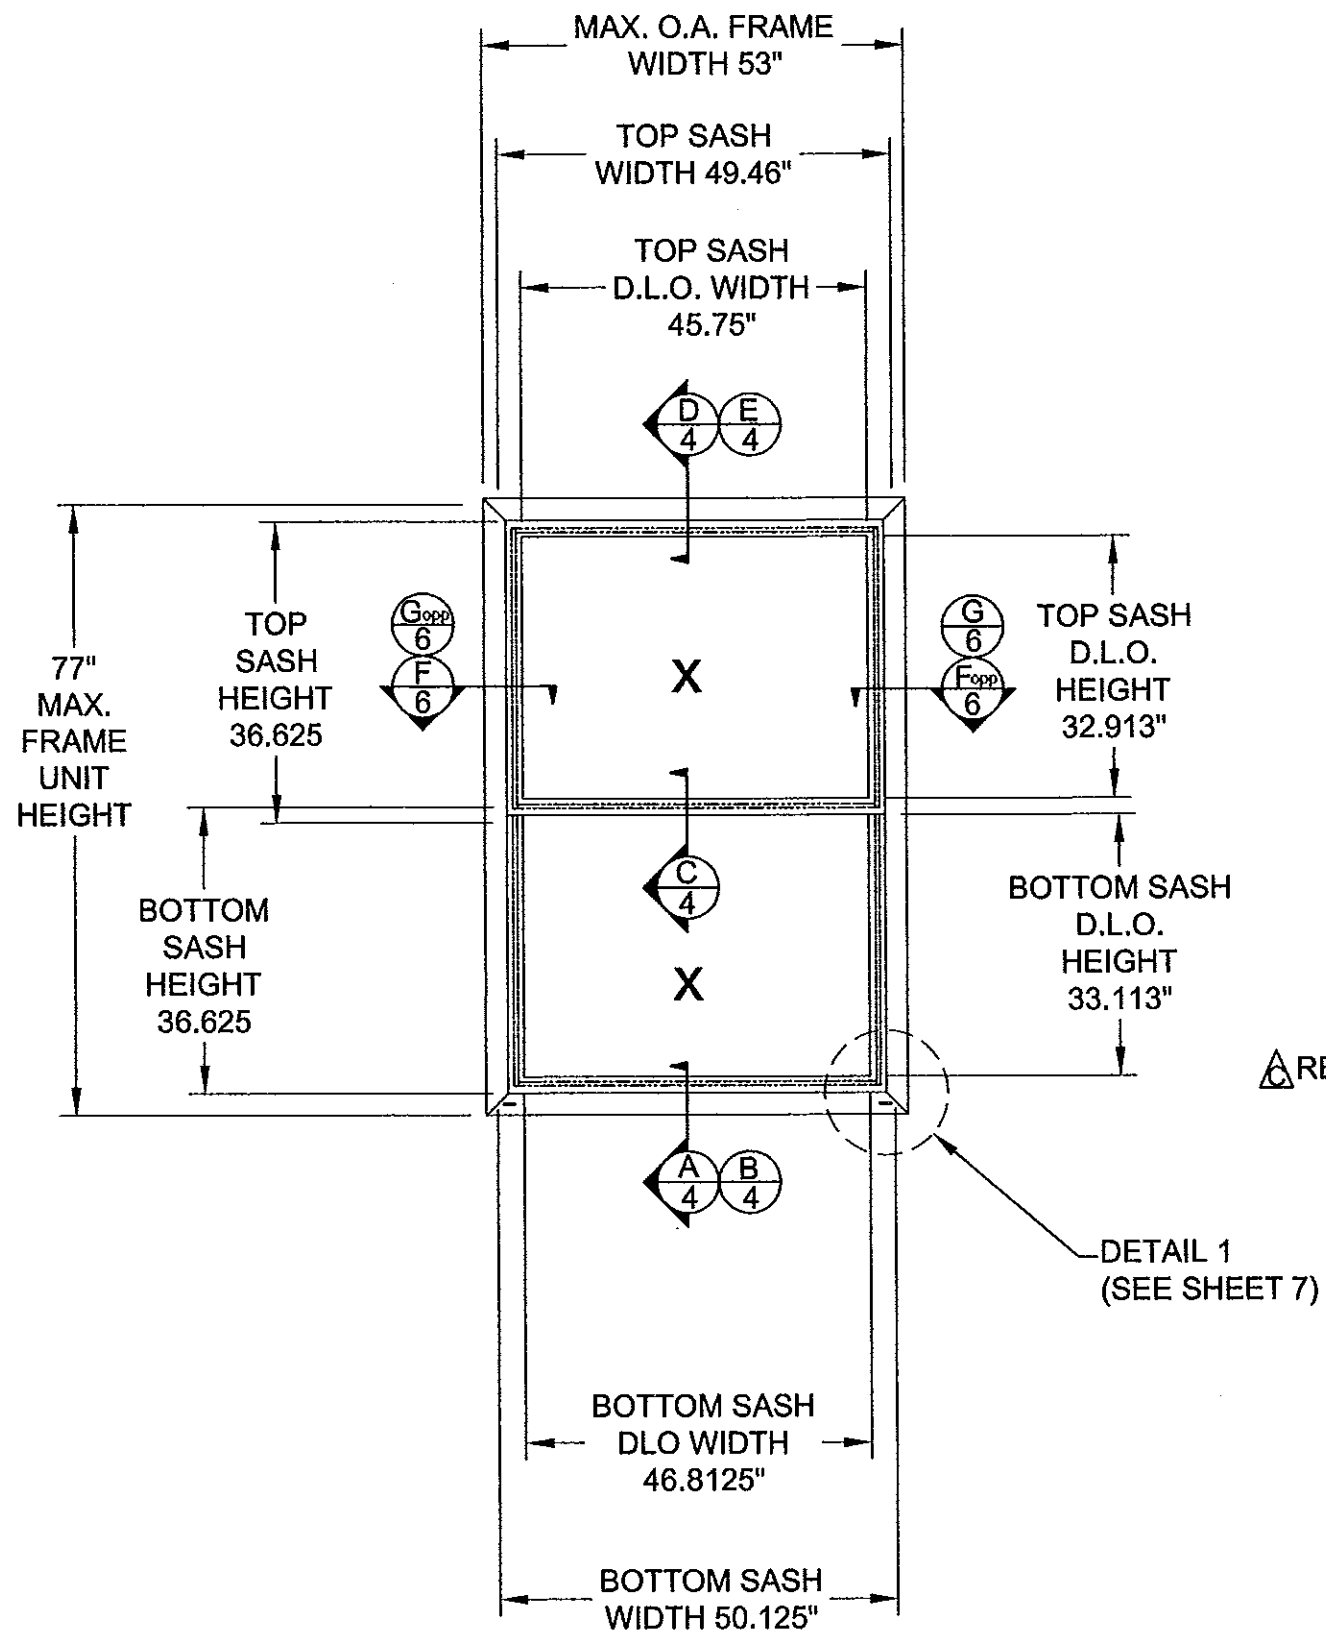

**ELEVATION**  
EXTERIOR VIEW  
W/O PARTING STOPS

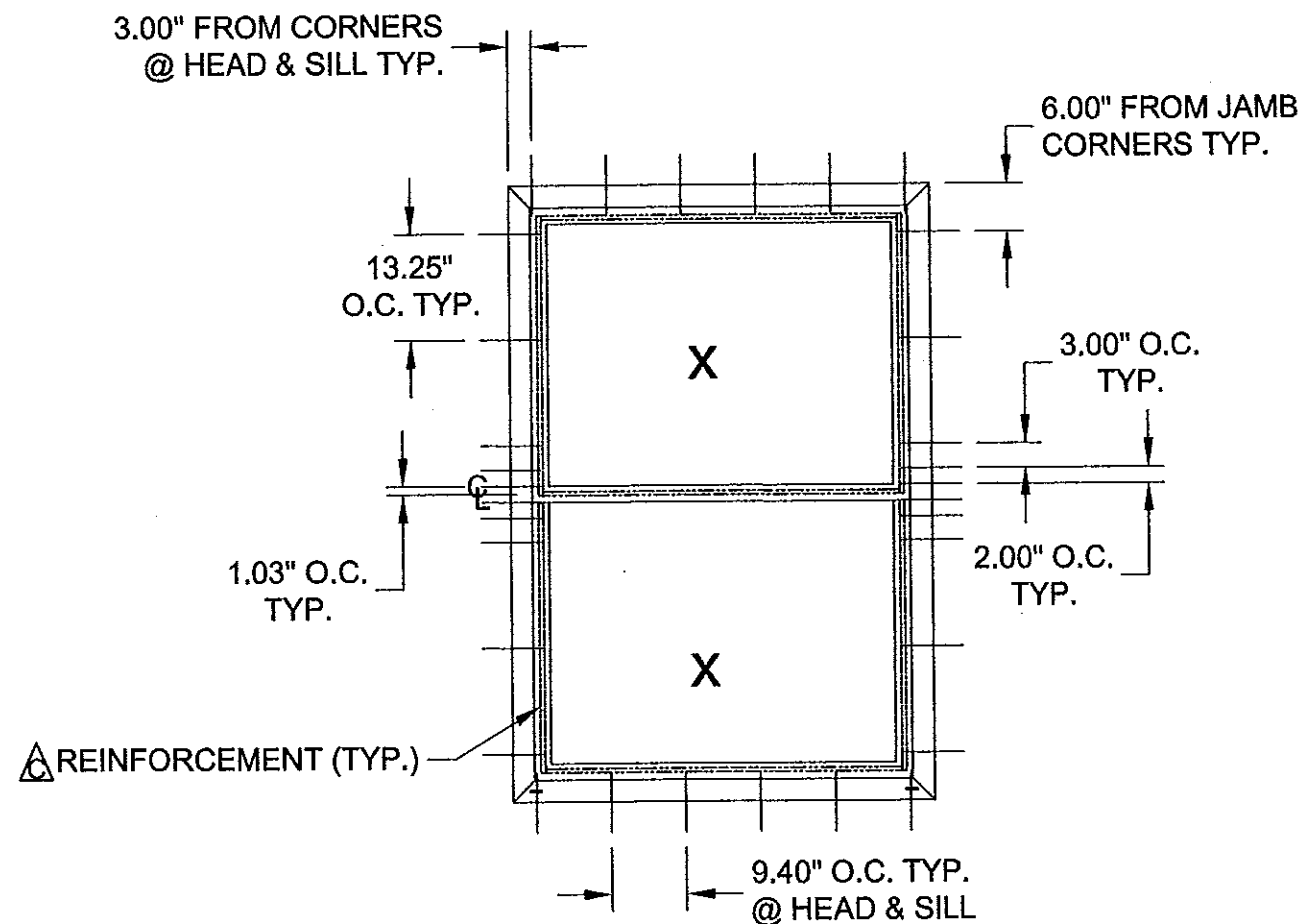


**ANCHOR LAYOUT**  
EXTERIOR VIEW  
W/O PARTING STOPS






PROJECT #413-1019		RJA	TJH	SMC	BY
REVISE PVC MANUF. AND NOA NO.		12/7/13	02/07/12	4/1/09	DATE
UPDATE TO		2010 FBC	PER MIAMI DADE COMMENTS 3/18/09	DESCRIPTION	REV
E	D	C	REV		

REGENCY PLUS 1024 LOCUST GAP HIGHWAY MT. CARMEL, PA 17851		DATE: 1/12/09	DRAWING NO: RPLS0084	SHEET: 3 OF 8
TITLE: SERIES 5305 TILT DOUBLE HUNG IMPACT VINYL WINDOW ELEVATION & ANCHOR LAYOUT		DRAWN BY: BB	SCALE:	REV: E
PTC Product Design Group, LLC PO Box 520775, Longwood, FL 32752-0775 321-690-1788 info@ptc-corp.com FBPE Cert. of Auth. No. 25935				

Robert J. Amoroso, P.E.  
Florida P.E. No. 49752

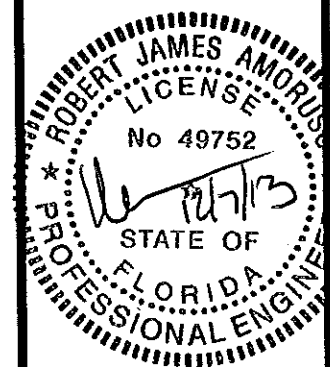


PRODUCT REVISED  
as complying with the Florida  
Building Code  
Acceptance No. 13-100710  
Expiration Date 12/16/2014  
By *Maurek*  
Miami Dade Product Control

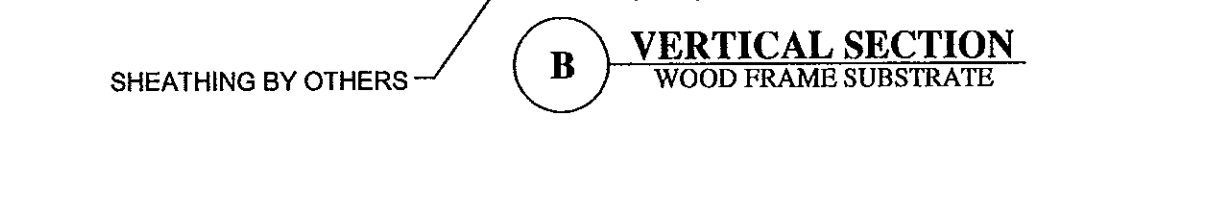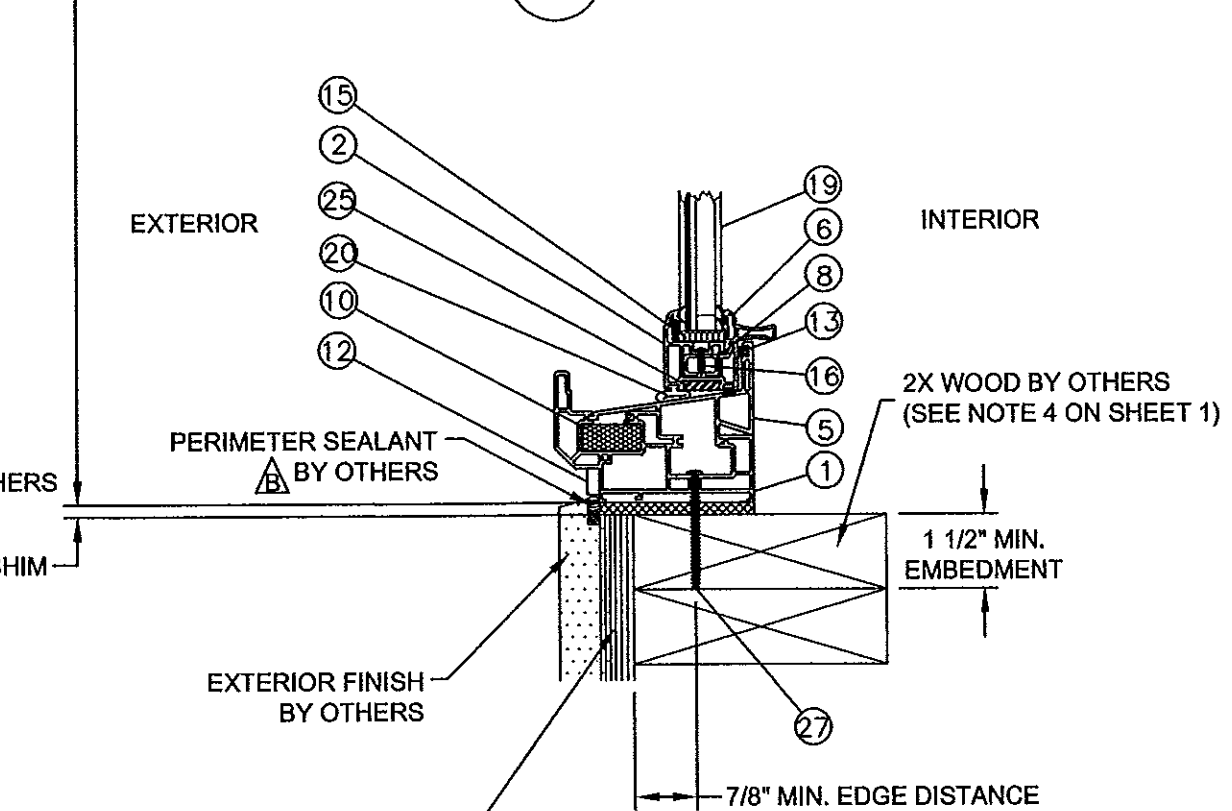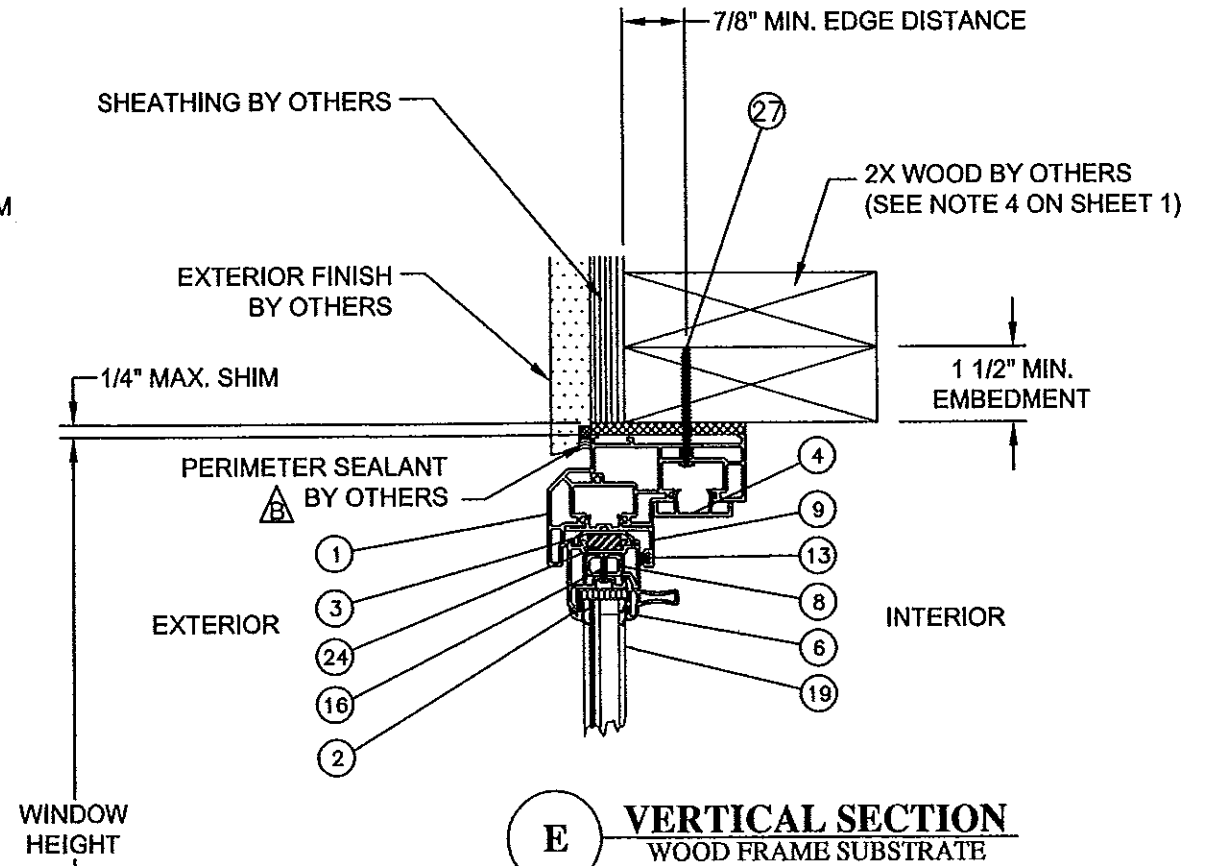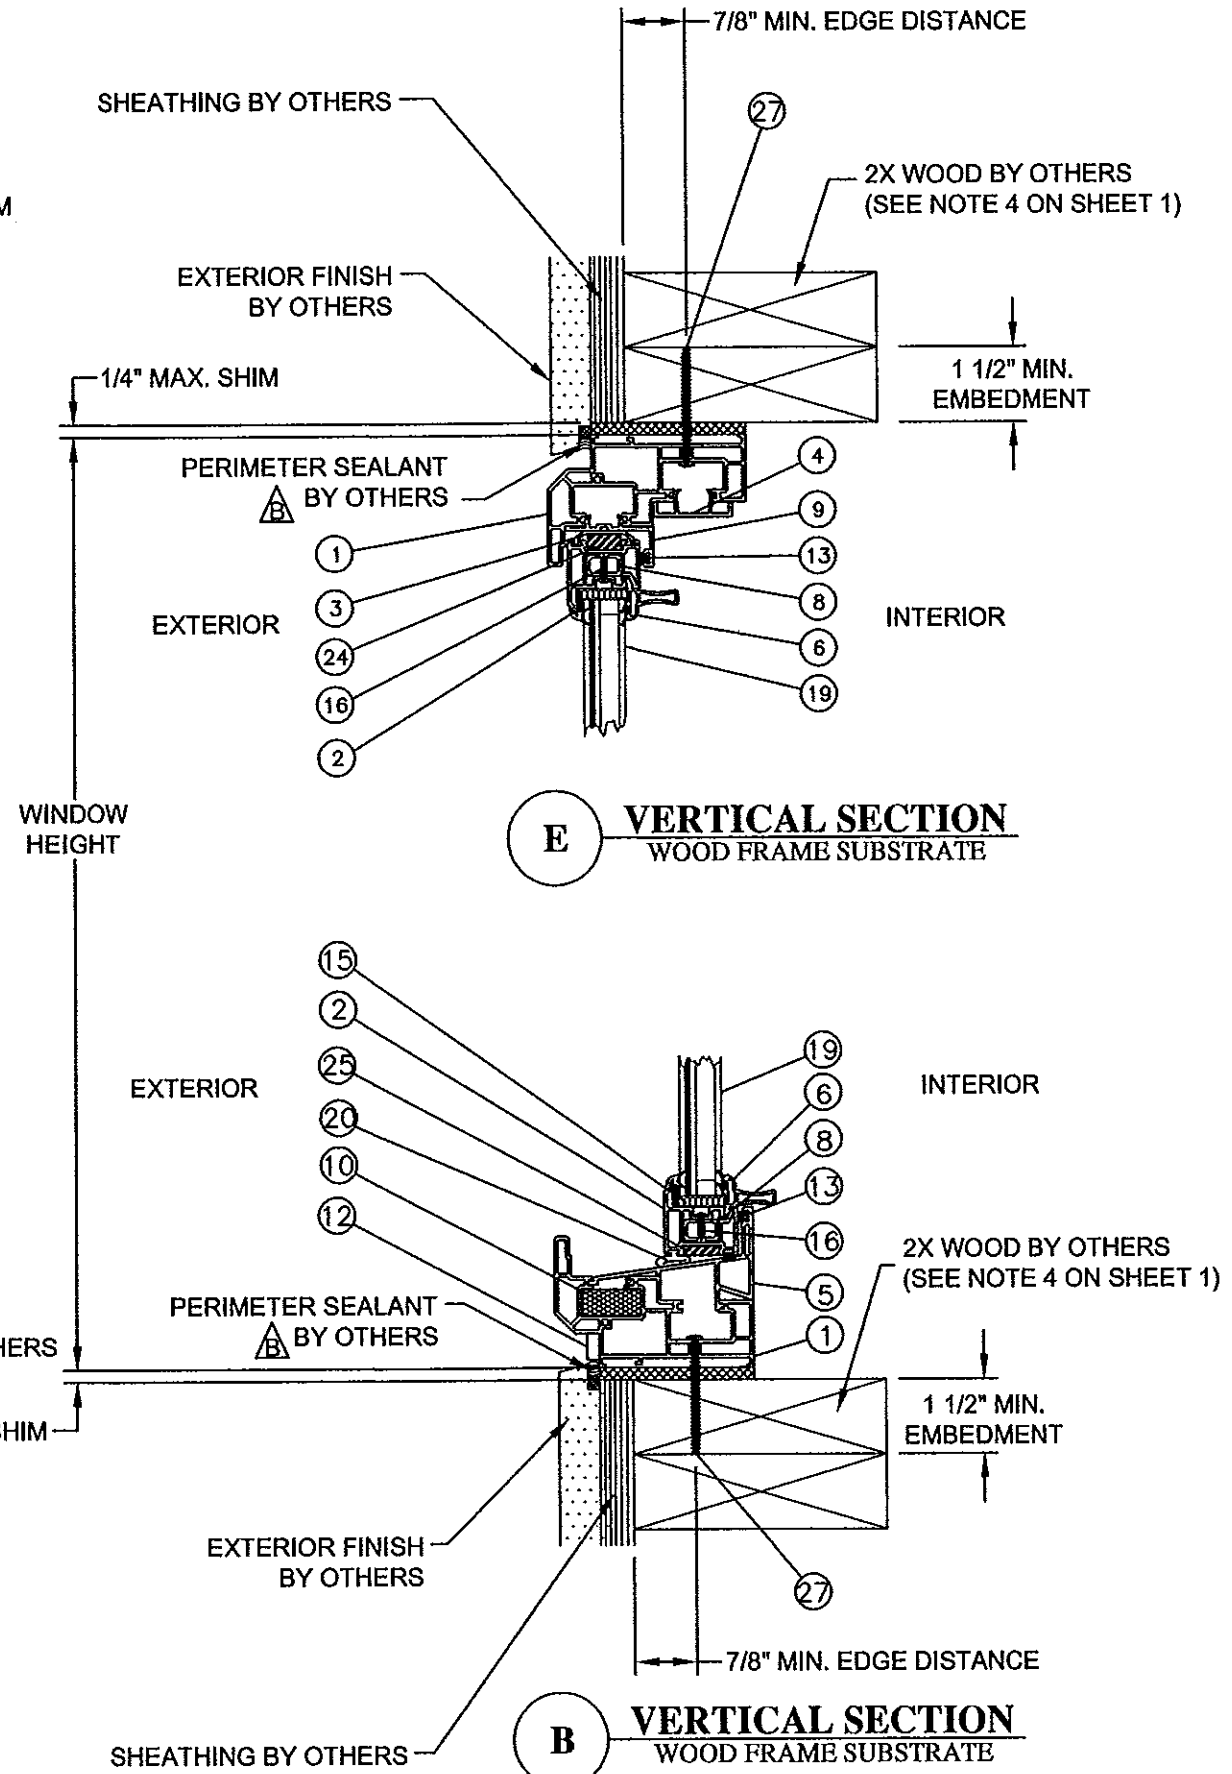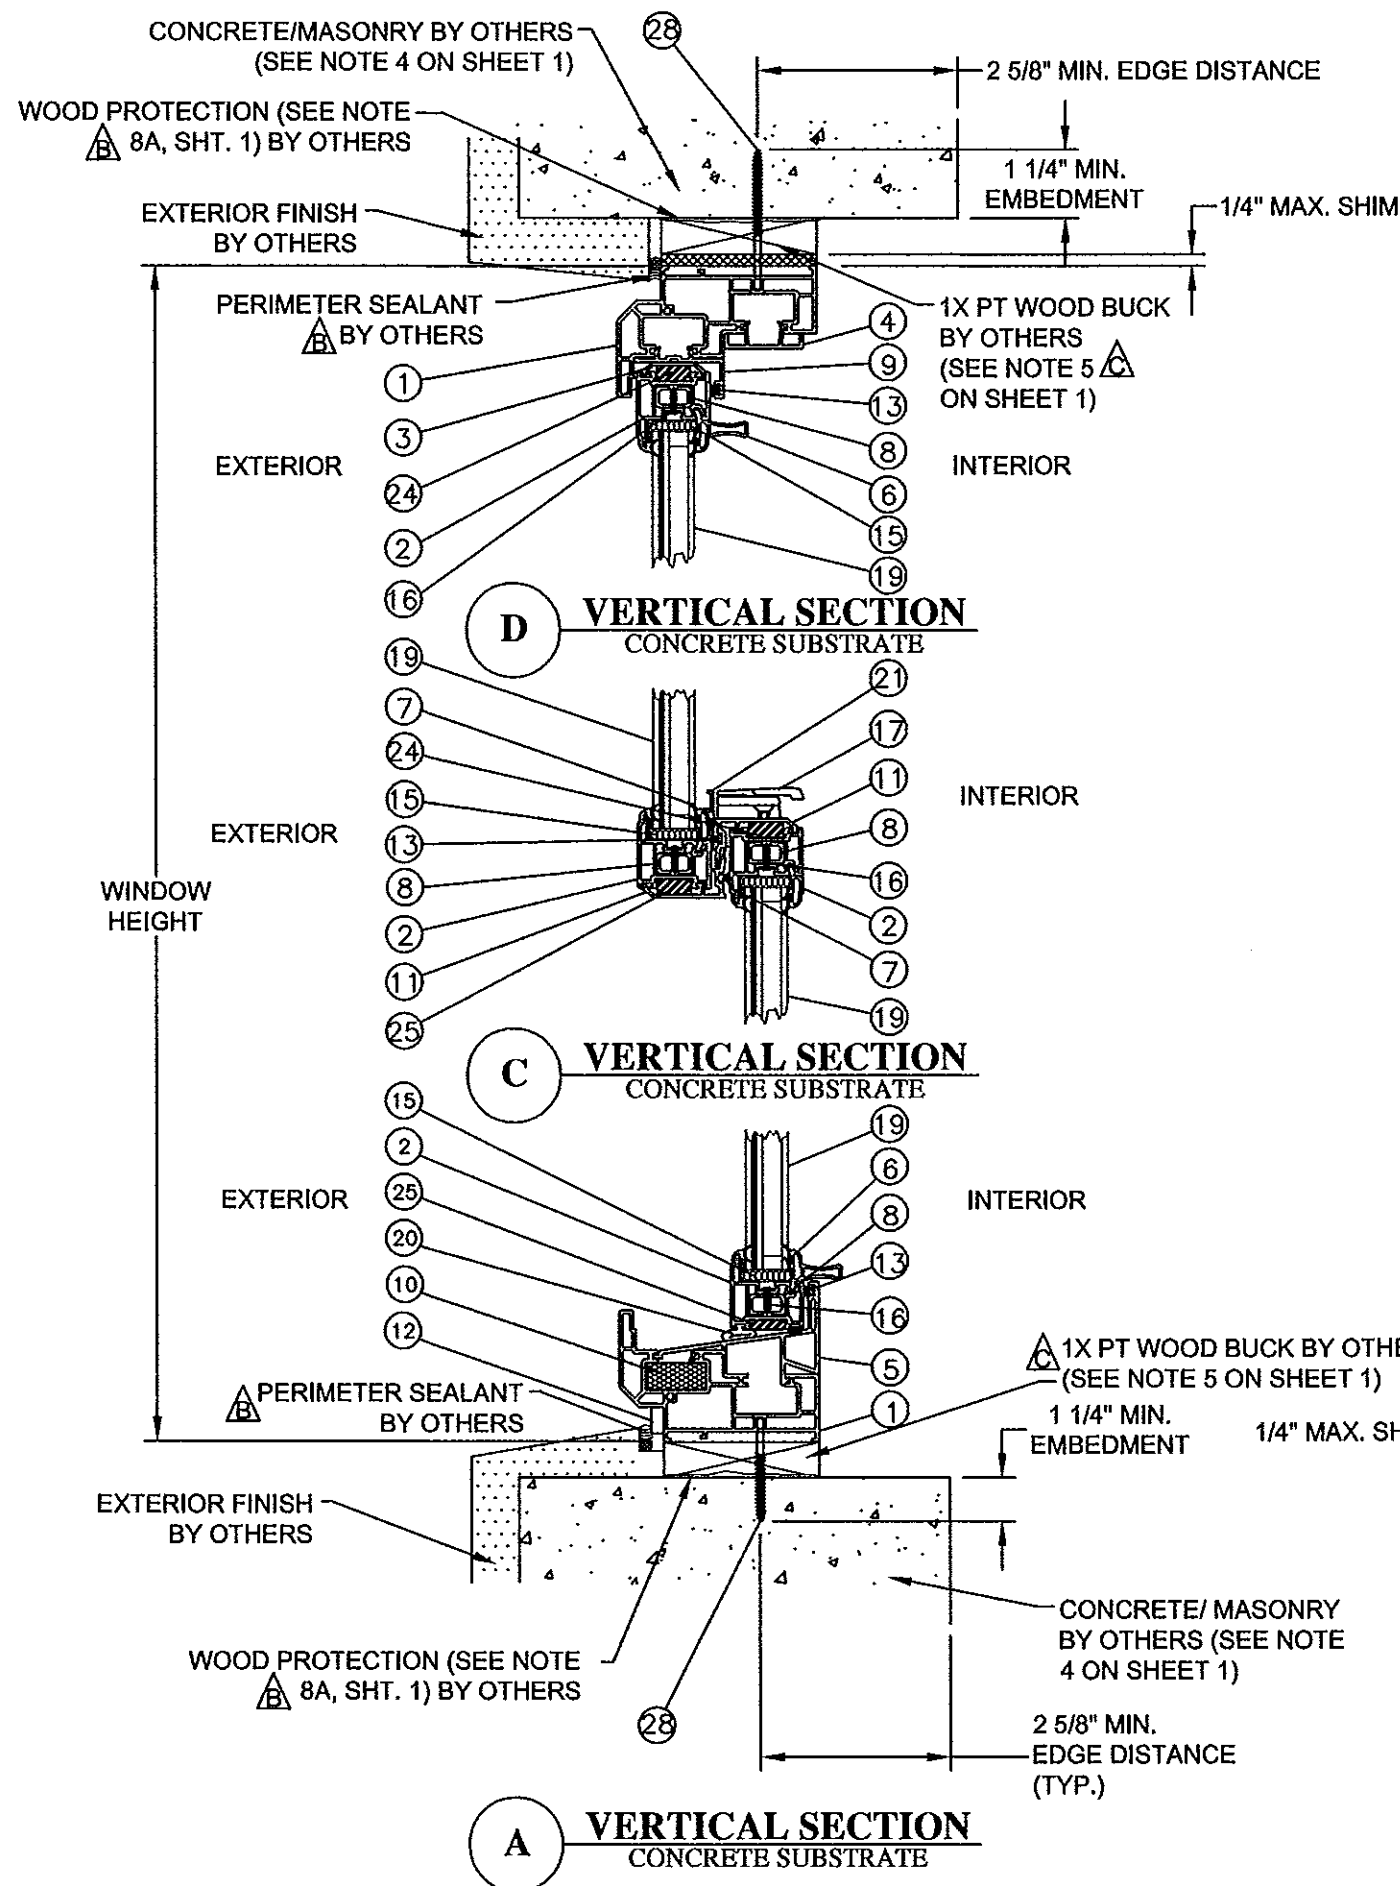


PROJECT #13-1019	REVISION	DATE	BY
12/7/13	RJA	02/07/12	TJH
12/7/13	REVISE PVC MANUF. AND NOA NO.	02/07/12	SMC
12/7/13	UPDATE TO 2010 FBC	02/07/12	SMC
12/7/13	PER MIAMI DADE COMMENTS 3/18/09	02/07/12	SMC
12/7/13	DESCRIPTION	DATE	BY
12/7/13	DESCRIPTION	DATE	BY

REGENCY PLUS	DATE: 1/12/09	DRAWING NO: RPLS0064	SHEET: 4 OF 8
1024 LOCUST GAP HIGHWAY	DATE: 1/12/09	DRAWING NO: RPLS0064	SHEET: 4 OF 8
MT. CARMEL, PA 17851	DATE: 1/12/09	DRAWING NO: RPLS0064	SHEET: 4 OF 8
TITLE: SERIES 5305 TILT DOUBLE HUNG IMPACT VINYL WINDOW VERTICAL SECTIONS	DATE: 1/12/09	DRAWING NO: RPLS0064	SHEET: 4 OF 8
PTC Product Design Group, LLC	DATE: 1/12/09	DRAWING NO: RPLS0064	SHEET: 4 OF 8
PO Box 520775, Longwood, FL 32752-0775	DATE: 1/12/09	DRAWING NO: RPLS0064	SHEET: 4 OF 8
321-690-1788 Info@ptc-corp.com	DATE: 1/12/09	DRAWING NO: RPLS0064	SHEET: 4 OF 8
FBPE Cert. of Auth. No. 25935	DATE: 1/12/09	DRAWING NO: RPLS0064	SHEET: 4 OF 8



Robert J. Amoroso, P.E.  
Florida P.E. No. 49752

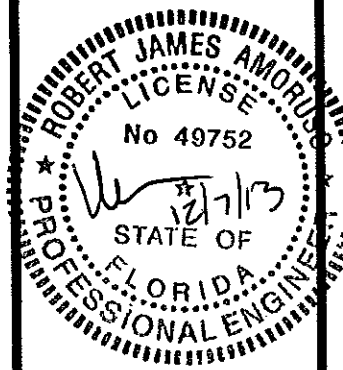


PRODUCT REVISED  
as complying with the Florida  
Building Code  
Acceptance No. 13-1007-10  
Expiration Date 12/6/2019  
By: [Signature]  
Miami Dade Product Control

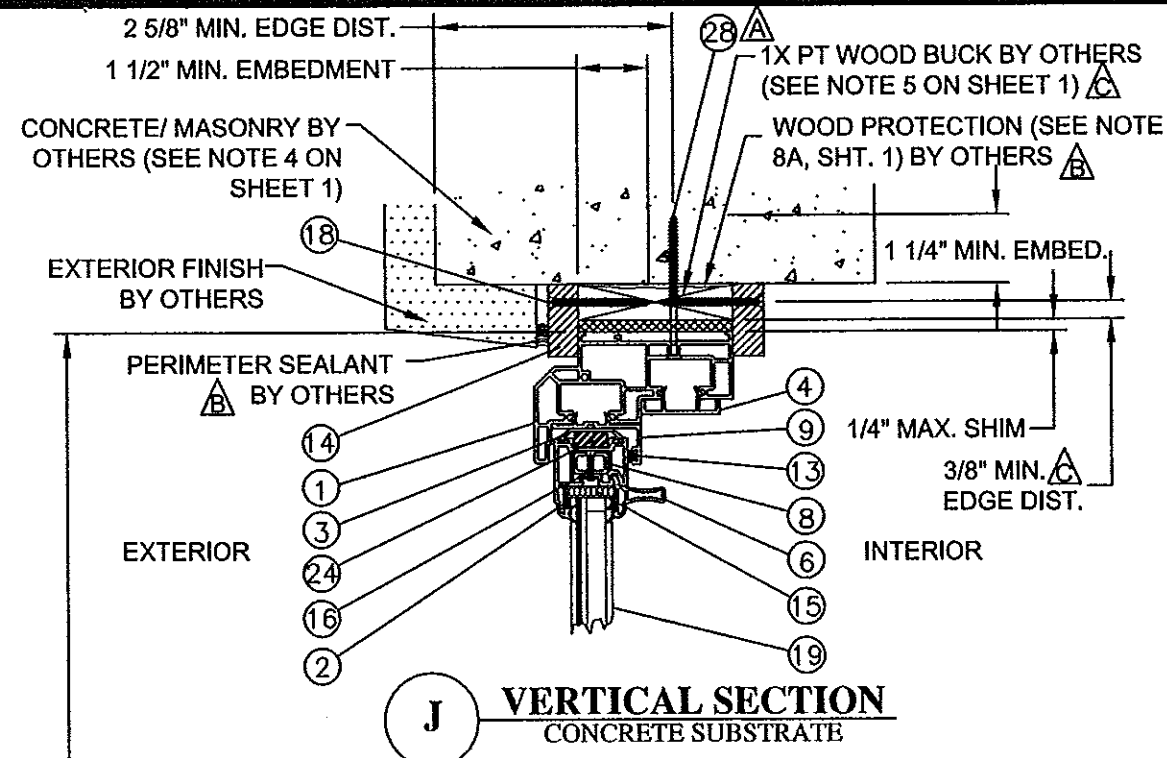

WINDOW  
HEIGHT

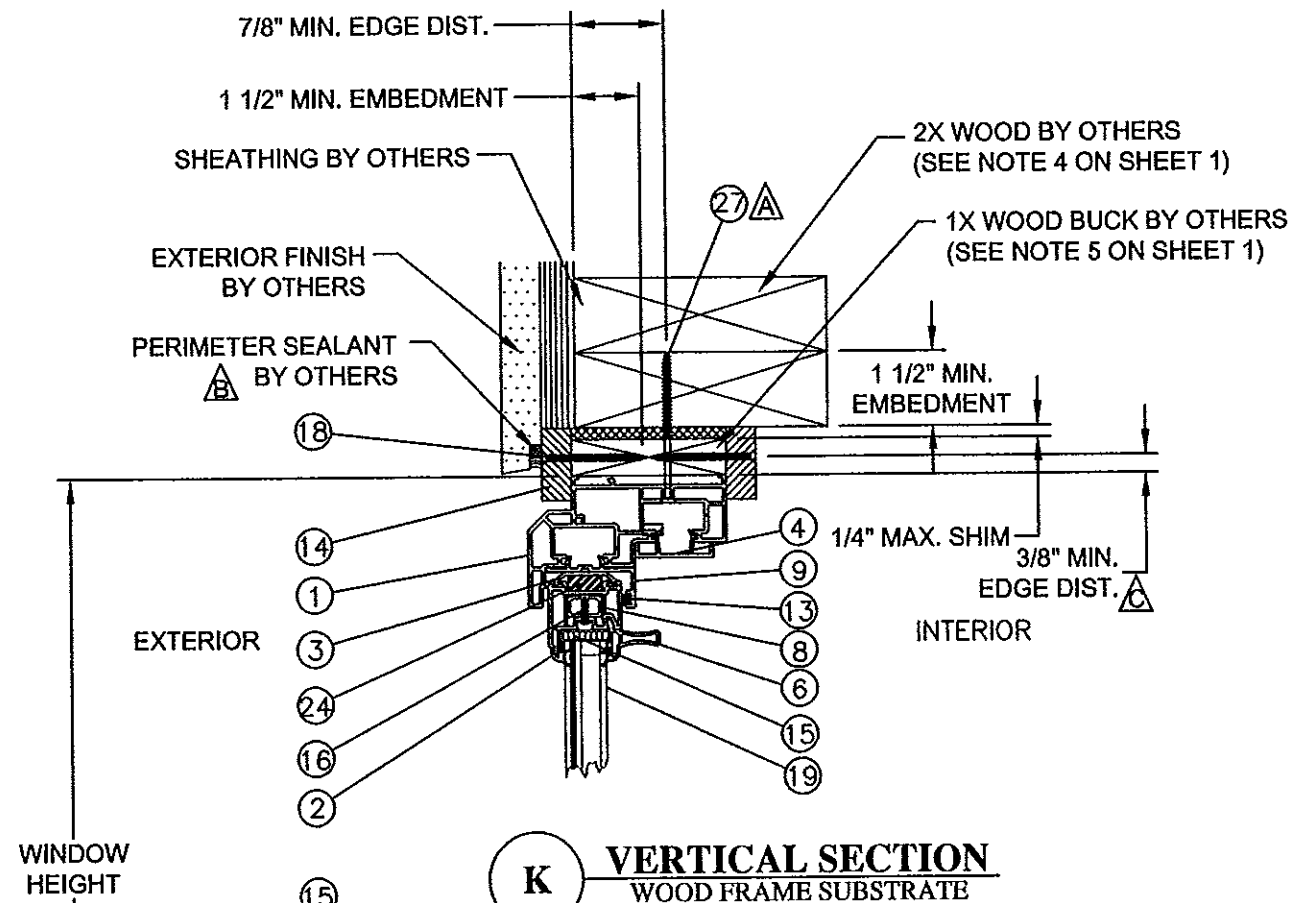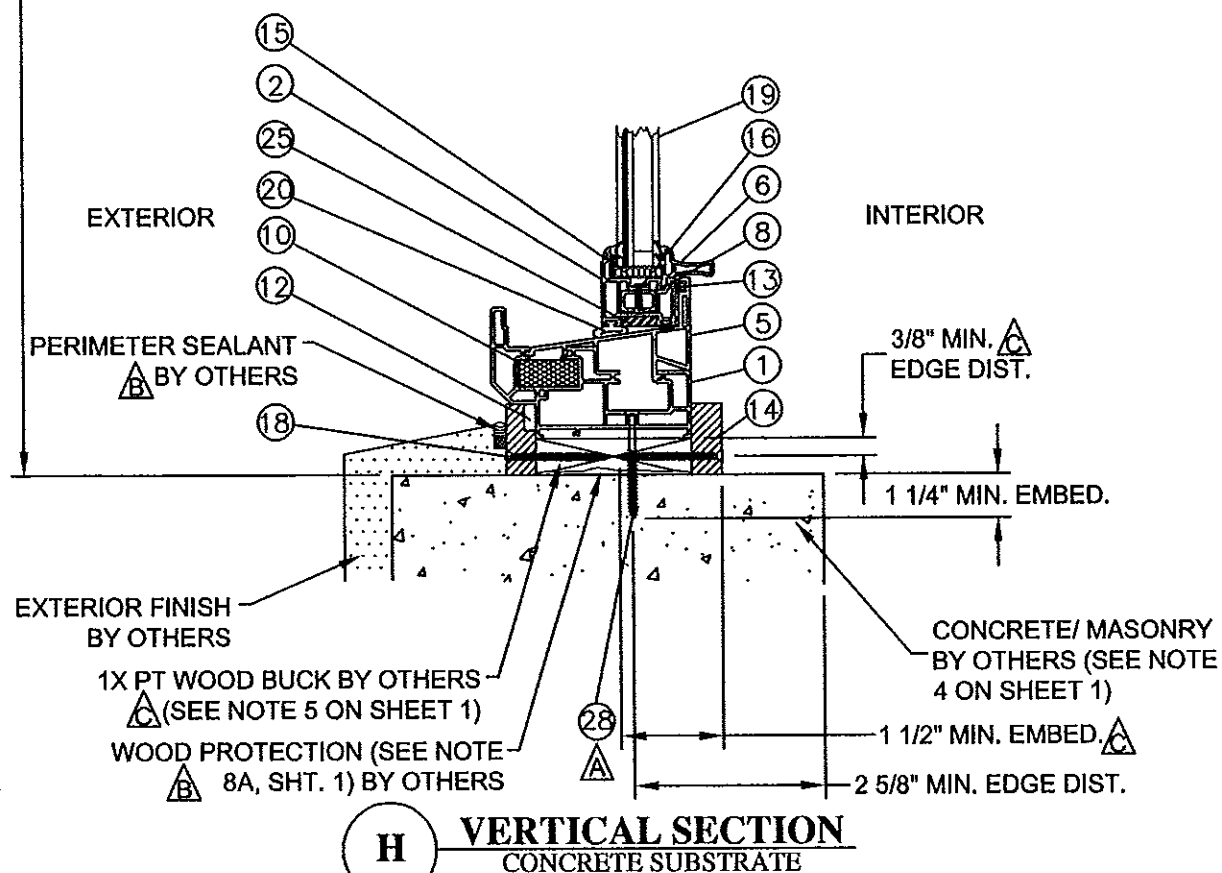

WINDOW  
HEIGHT

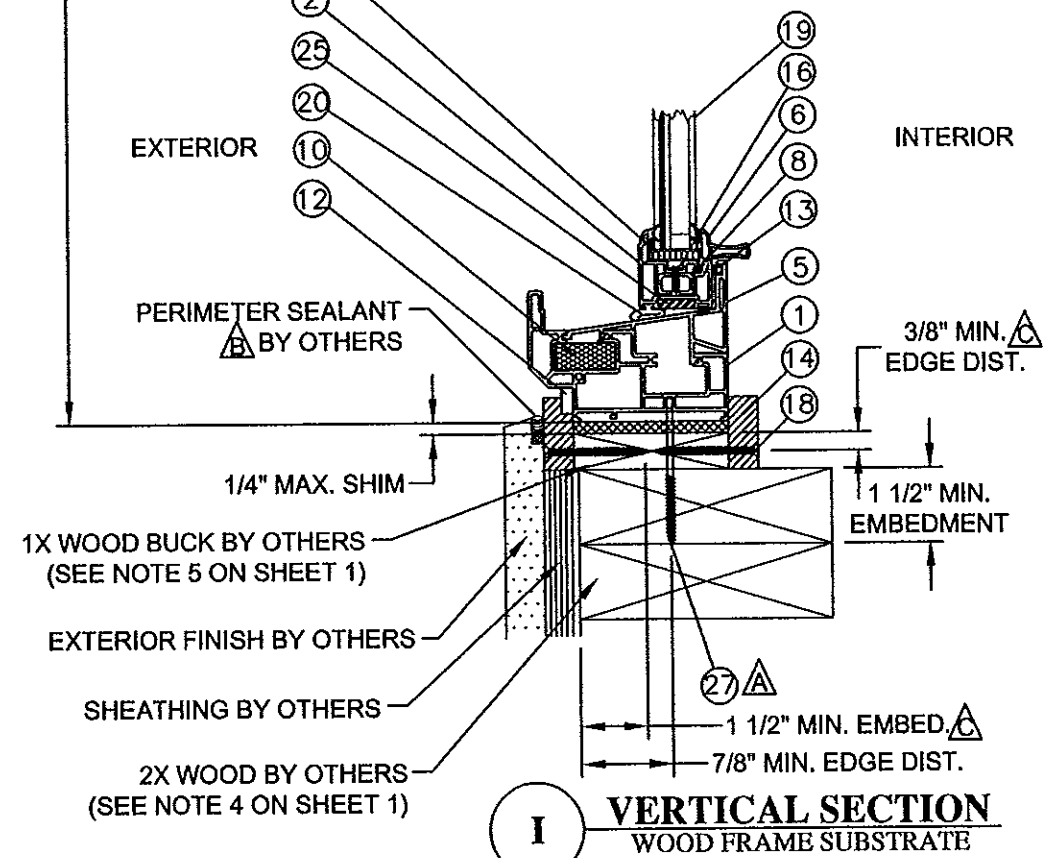

PROJECT #413-1019


REV	DESCRIPTION	DATE	BY
E	REVISE PVC MANUF. AND NOA NO.	12/7/13	RJA
D	UPDATE TO 2010 FBC	02/07/12	TJH
C	PER MIAMI DADE COMMENTS 3/18/09	4/1/09	SMC

REGENCY PLUS  
1024 LOCUST GAP HIGHWAY  
MT. CARMEL, PA 17851  
TITLE: SERIES 5305 TILT DOUBLE HUNG IMPACT VINYL WINDOW  
VERTICAL SECTIONS

DATE	1/12/09
DRAWING NO.	RPLS0064
SCALE	
REV	E
SHEET	5 OF 8


PTC Product Design Group, LLC  
321-690-1788 info@ptc-corp.com  
FBPE Cert. of Auth. No. 25935

Robert J. Amoroso, P.E.  
Florida P.E. No. 49752

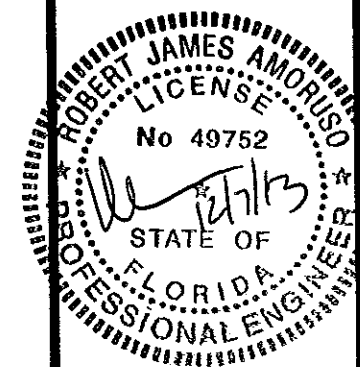


PRODUCT REVISED  
as complying with the Florida  
Building Code  
Acceptance No. 13-100710  
Expiration Date May 6, 2019  
By *Manuel Ruiz*  
Miami Dade Product Control




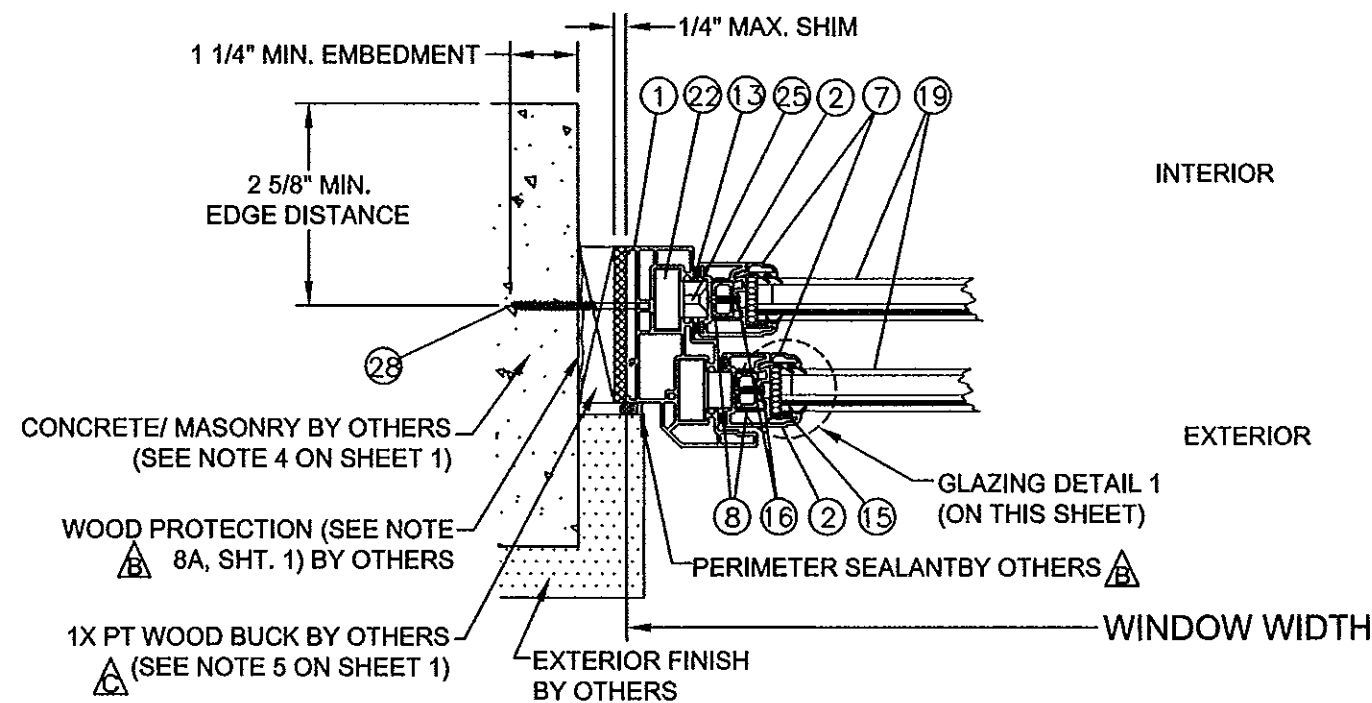


**F HORIZONTAL SECTION**  
CONCRETE/MASONRY SUBSTRATE

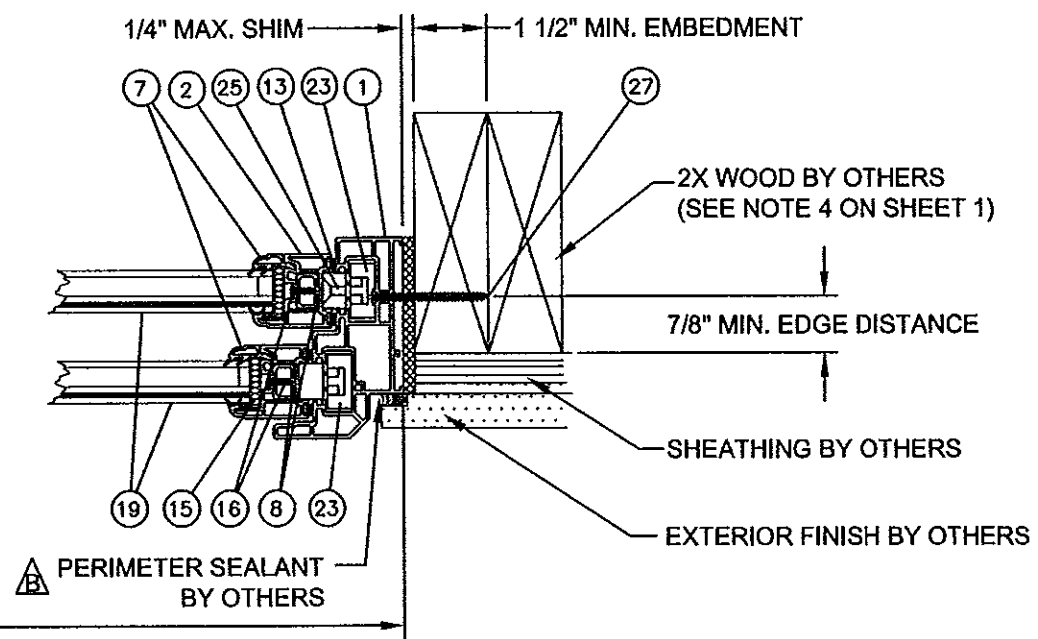


**G HORIZONTAL SECTION**  
WOOD FRAME SUBSTRATE

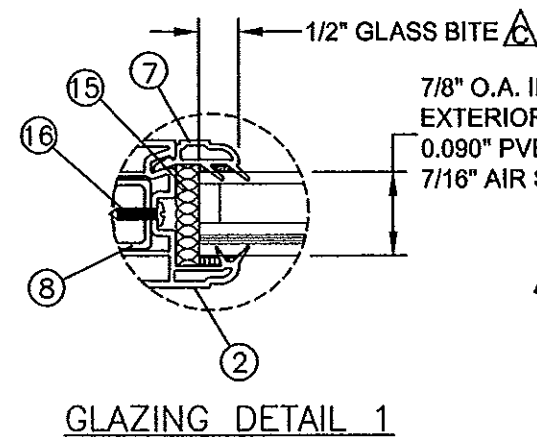

**GLAZING DETAIL 1**

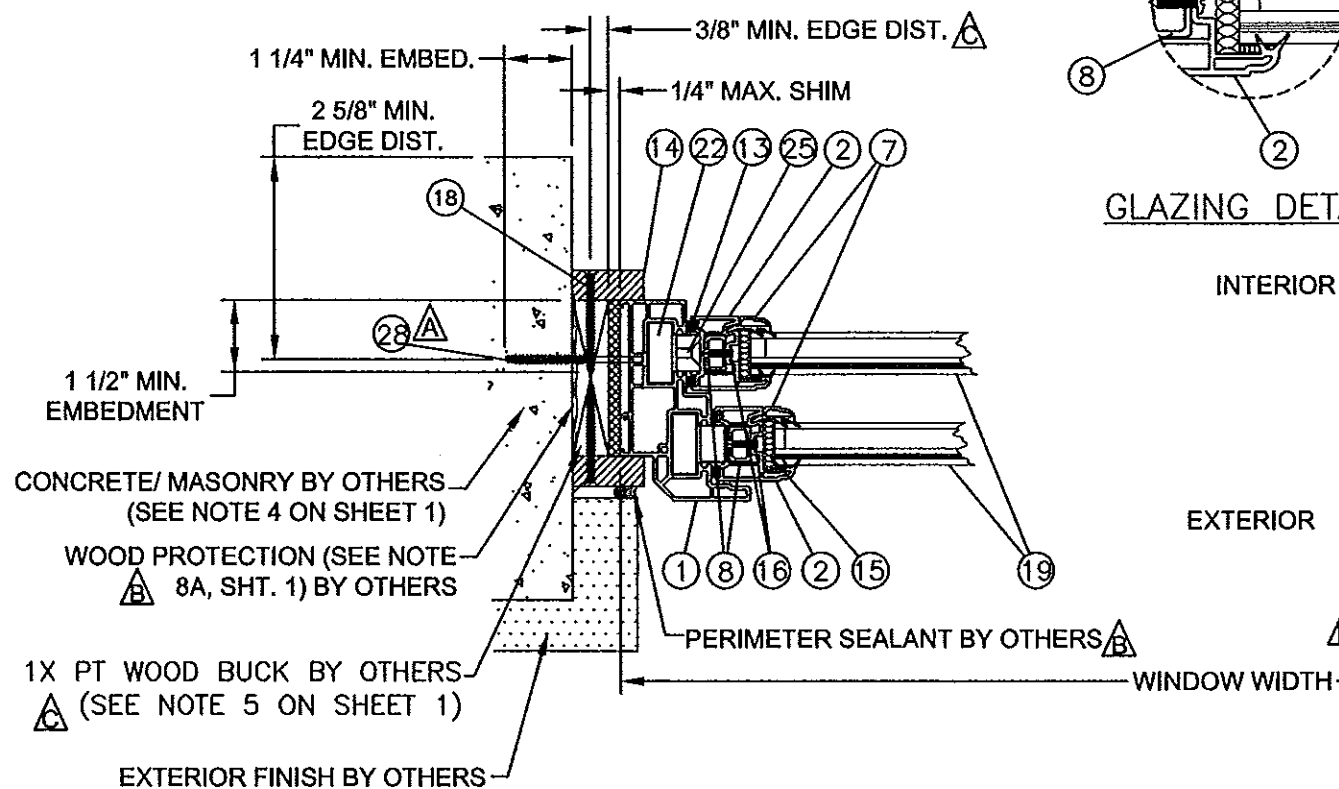

**J HORIZONTAL SECTION**  
CONCRETE/MASONRY SUBSTRATE

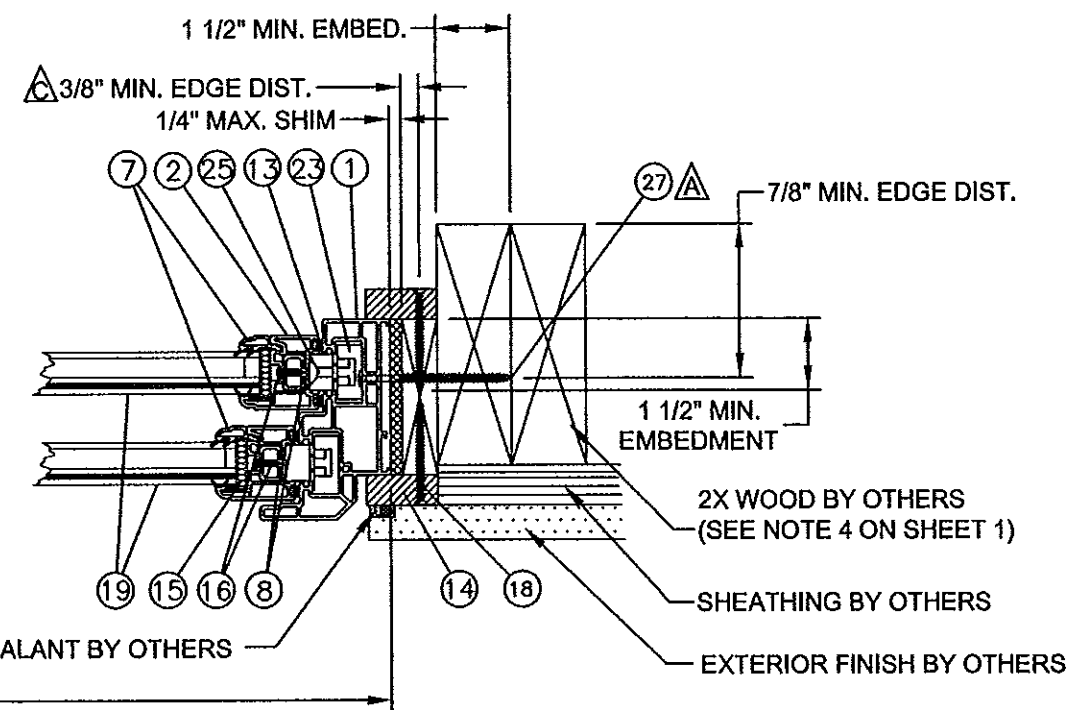


**K HORIZONTAL SECTION**  
WOOD FRAME SUBSTRATE

PROJECT #413-1019	RJA	TJH	SMC	BY
REVISE PVC MANUF. AND NOA NO.	12/7/13	02/07/12	4/1/09	DATE
UPDATE TO 2010 FBC				
PER MIAMI DADE COMMENTS 3/18/09				
DESCRIPTION				
REV				





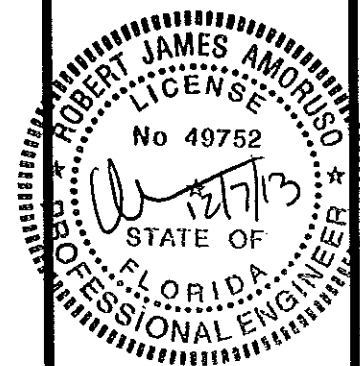






REGENCY PLUS	DATE	1/12/09	DRAWING NO.	RPLS0064	SHEET	6 OF 8
1024 LOCUST GAP HIGHWAY	BB		SCALE			
MT. CARMEL, PA 17851			REV	E		
TITLE: SERIES 5305 TILT DOUBLE HUNG IMPACT VINYL WINDOW						
HORIZONTAL SECTIONS						
PTC Product Design Group, LLC						
PO Box 520775, Longwood, FL 32752-0775						
321-690-1788 info@ptc-corp.com						
FBPE Cert. of Auth. No. 25935						


Robert J. Amoroso, P.E.  
Florida P.E. No. 49752




PRODUCT REVISED  
as complying with the Florida  
Building Code  
Acceptance No 13-1007-10  
Expiration Date May 6, 2019  
By Miami Dade Product Control

# BILL OF MATERIALS

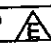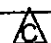
ITEM #	DESCRIPTION	MATERIAL	MANUFACTURER
1	MAIN FRAME	WHITE RIGID PVC	**RWDP 
2	SASH PANEL FRAME	WHITE RIGID PVC	**RWDP 
3	SASH COVER	WHITE RIGID PVC	**RWDP 
4	PANEL STOP / FRAME COVER	WHITE RIGID PVC	**RWDP 
5	SLOPED SILL COVER	WHITE RIGID PVC	**RWDP 
6	GLAZING STOP WITH HANDLE	WHITE RIGID PVC	**RWDP 
7	GLAZING STOP (OPERABLE SASH)	WHITE RIGID PVC	**RWDP 
8	REINFORCEMENT	STEEL	ROLL TECH INDUSTRIES
9	POCKET COVER #1	WHITE RIGID PVC	**RWDP 
10	BUG STRIP	VINYL	-----
11	INTERLOCK COVER	WHITE RIGID PVC	**RWDP 
12	WEEP COVER	NYLON	CUSTOM CRAFT
13	0.210" / 0.187" x 0.300" CENTER FIN WEATHERSTRIP	-----	ULTRAFAB
14	3/4" X 1 1/2" PARTING STOP (SEE NOTE 8A, SHT. 1) G= 0.55 MIN. 	PT PINE WOOD 	-----
15	SIKAFLEX 552 SILICONE	SILICONE	SIKA CORP.
16	#8 X 1/2" TEK SCREW	STEEL	-----
17	CAM TYPE SWEEP LOCK	STEEL	TRUTH HARDWARE
18	#8 WOOD SCREW	STEEL	-----
19	7/8" O.A. INSULATED GLASS CONSISTING OF: DSB ANNEALED GLASS, 0.090" INTERLAYER BY DUPONT, DSB ANNEALED GLASS, AIR SPACE, DSB TEMPERED GLASS	GLASS	-----
20	BULB VINYL WEATHERSTRIP	VINYL	UNIVERSAL POLYMERE & RUBBER
21	FACE MOUNTED KEEPER	STEEL	TRUTH HARDWARE
22	SPRING BALANCE	-----	BSI HARDWARE
23	LOCKING TILT SHOE	NYLON	BSI BALANCE SYSTEMS
24	TILT LATCH	ZINC	VISION INDUSTRIES
25	PIVOT BAR	METAL	VISION INDUSTRIES
26	SIKAFLEX 552 BACKBEDDING	SILICONE	SIKA CORP.
27	#12 WOOD SCREW	STEEL	-----
28	3/16" ITW TAPCON SCREWS	STEEL	ITW

 \*\* RWDP: ROYAL WINDOWS AND DOOR  
PROFILES, PLANT NO. 13 (NOA NO. 12-1120.02).


17 SASH LOCK  
STEEL  
TYP. WALL THICKNESS NA

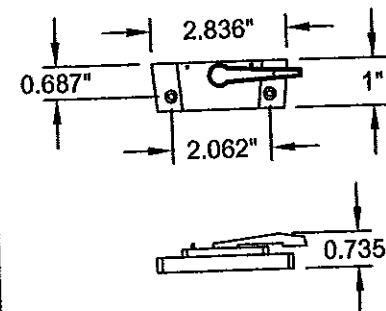


23 LOCKING TILT SHOE  
NYLON  
TYP. WALL THICKNESS NA

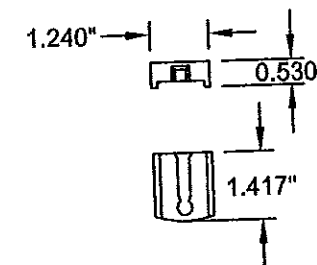


PANEL STOP / FRAME  
COVER  
4 WHITE RIGID PVC  
TYP. WALL  
THICKNESS 0.070"

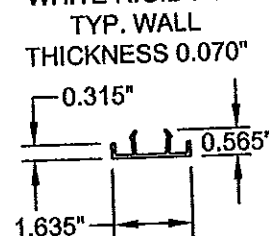


21 FACE MOUNTED KEEPER  
STEEL  
TYP. WALL THICKNESS 0.070"

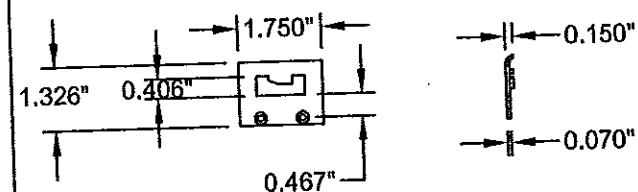


9 POCKET COVER  
WHITE RIGID PVC  
TYP. WALL  
THICKNESS 0.070"

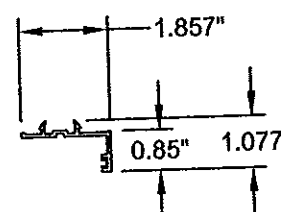


22 SPRING BALANCE

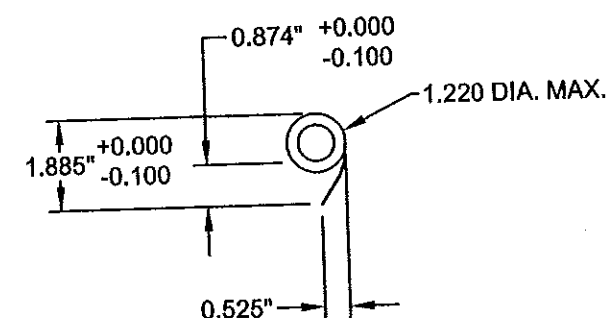


1 MAIN FRAME  
WHITE RIGID PVC  
TYP. WALL THICKNESS 0.070"

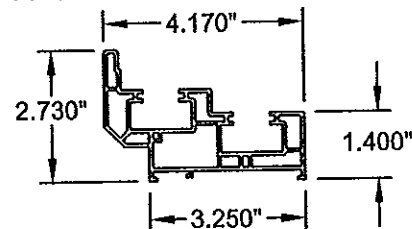


2 SASH PANEL FRAME  
WHITE RIGID PVC  
TYP. WALL THICKNESS 0.070"

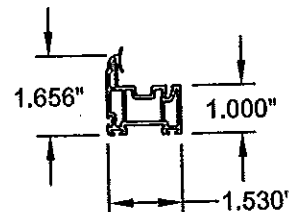


3 SASH COVER  
WHITE RIGID PVC  
TYP. WALL THICKNESS 0.065"

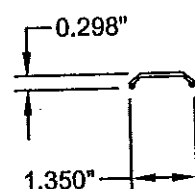


5 SLOPED SILL COVER  
WHITE RIGID PVC  
TYP. WALL THICKNESS 0.075"

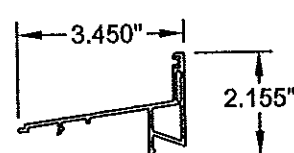


GLAZING STOP / LIFT HANDLE  
WHITE RIGID PVC  
TYP. WALL THICKNESS 0.055"

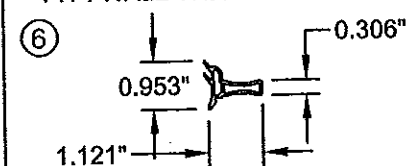


7 GLAZING STOP (OPERABLE SASH)  
WHITE RIGID PVC  
TYP. WALL THICKNESS 0.055"

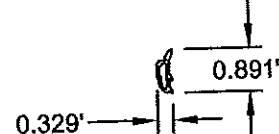


8 REINFORCEMENT  
STEEL  
TYP. WALL THICKNESS 0.062"

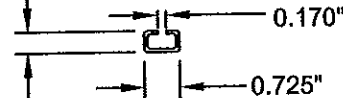

11 INTERLOCK COVER  
WHITE RIGID PVC  
TYP. WALL THICKNESS 0.075"

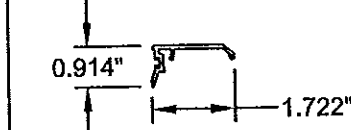

14 PARTING STOP  
WOOD

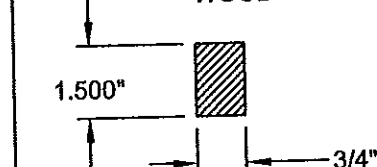

PROJECT #413-1019


REV	DESCRIPTION	DATE	BY
E	REVISE PVC MANUF. AND NOA NO.	12/7/13	RJA
D	UPDATE TO 2010 FBC	02/07/12	TJH
C	PER MIAMI DADE COMMENTS 3/18/09	4/1/09	SMC

REGENCY PLUS  
1024 LOCUST GAP HIGHWAY  
MT. CARMEL, PA 17851  
TITLE: SERIES 5305 TILT DOUBLE HUNG IMPACT VINYL WINDOW  
BILL OF MATERIALS & COMPONENTS

DATE:	1/12/09
DRAWN BY:	BB
SCALE:	RPLS0064
REV:	E
SHEET:	7 OF 8


PTC Product Design Group, LLC  
PO Box 520775, Longwood, FL 32752-0775  
321-690-1788 info@ptc-corp.com  
FBPE Cert. of Auth. No. 25985

Robert J. Amoroso, P.E.  
Florida P.E. No. 49752


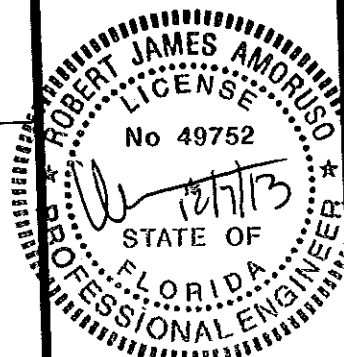


PRODUCT REVISED  
is complying with the Florida  
Building Code  
Acceptance No. 13-1007-10  
Expiration Date 12/31/2019  
By: *Manuel Sney*  
Miami Dade Product Control

24 TILT LATCH  
ZINCTYP. WALL THICKNESS NA

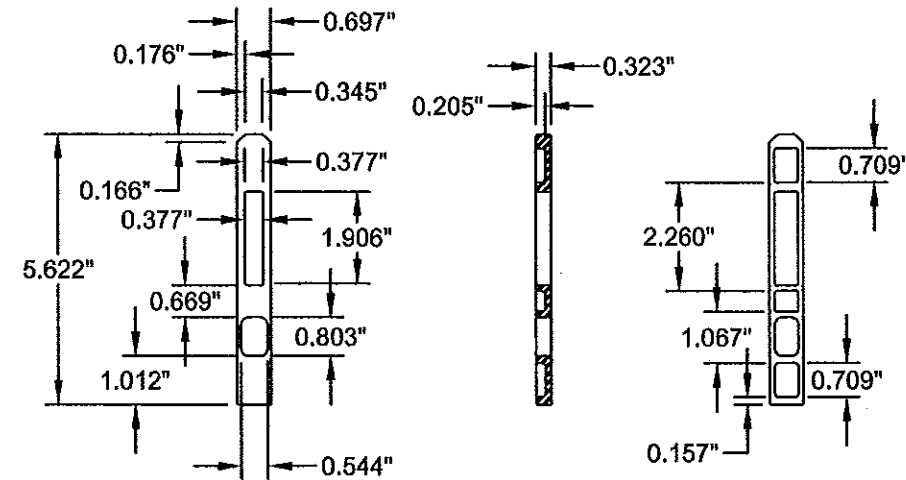

25 PIVOT BAR  
METALTYP. WALL THICKNESS NA

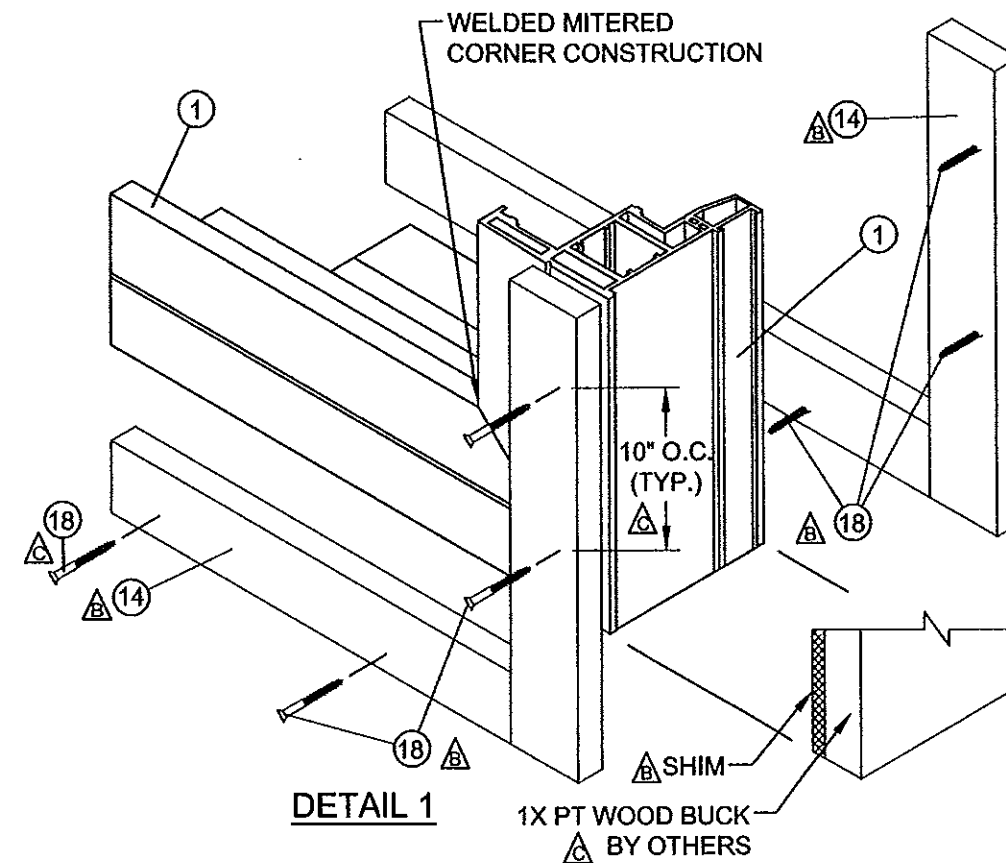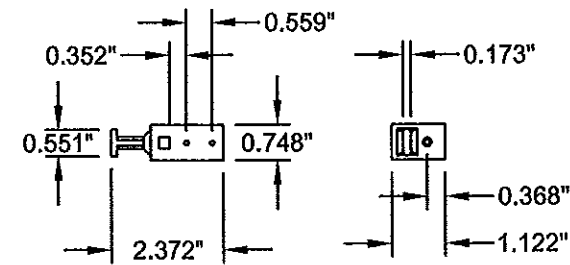


NOTE:  
PARTING STOP EXTERIOR PERIMETER  
TO BE SEALED TO 1X PT WOOD BUCK  
WITH SIKA 551 SILICONE

PROJECT #413-1019	REVISION	DATE	BY
REVIS PVC MANUF. AND NOA NO.	12/7/13	RJA	
UPDATE TO 2010 FBC	02/07/12	TJH	
PER MIAMI DADE COMMENTS 3/18/09	4/1/09	SMC	
DESCRIPTION			

REGENCY PLUS 1024 LOCUST GAP HIGHWAY MT. CARMEL, PA 17851	DRAWN BY: BB	DATE: 1/12/09	SHEET: 8 OF 8
TITLE: SERIES 5305 TILT DOUBLE HUNG IMPACT VINYL WINDOW COMPONENTS & CORNER DETAIL	SCALE:	DRAWING NO: RPLS00064	REV: E
PTC Product Design Group, LLC PO Box 520775, Longwood, FL 32752-0775 321-690-1788 info@ptc-corp.com FBPE Cert. of Auth. No. 25935			

Robert J. Amoroso, P.E.  
Florida P.E. No. 49752

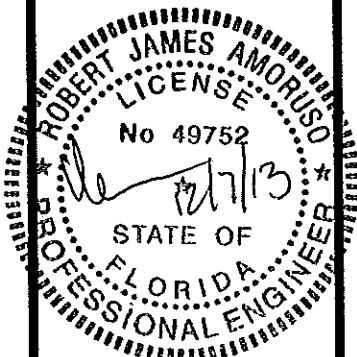

PRODUCT REVISED  
as complying with the Florida  
Building Code  
Acceptance No 13-1007.10  
Expiration Date 12/6/2019  
By *Wmuel Yere*  
Miami Dade Product Control